



D.O.B. DISCLAIMER:
THIS PLAN IS APPROVED ONLY FOR WORK INDICATED ON THE APPLICATION SPECIFICATION SHEET. ALL OTHER MATTERS SHOWN ARE NOT TO BE RELIED UPON OR TO BE CONSIDERED AS EITHER BEING APPROVED OR IN ACCORDANCE WITH APPLICABLE CODES.

5 02.16.21 ADDENDUM #1 △
4 01.29.21 ISSUED FOR 100% CD
3 04.03.20 BID SET
2 10.07.19 100% SUBMISSION - ISSUED FOR BID
1 09.20.19 90% SUBMISSION - ISSUED FOR BID
NO. DATE DESCRIPTION
ISSUE / REVISION

Ronnette Riley *Architect*

494 Eighth Avenue, 15th Floor
New York, NY 10001
T: 212 594 4015
F: 212 594 2868
www.ronnetteriley.com

ARCHITECT

CONSULTANTS



CAMERON ENGINEERING & ASSOCIATES OF NEW YORK, PLLC

1411 Broadway, Suite 610 New York, NY 10018
117 Crossways Park Drive Woodbury, NY 11797
Corporate Seal Initiated 2012 State of New York
www.CameronEngineering.com

T: (212) 324-4000
F: (212) 827-4000
E: (914) 211-8000

COPYRIGHT

PROJECT

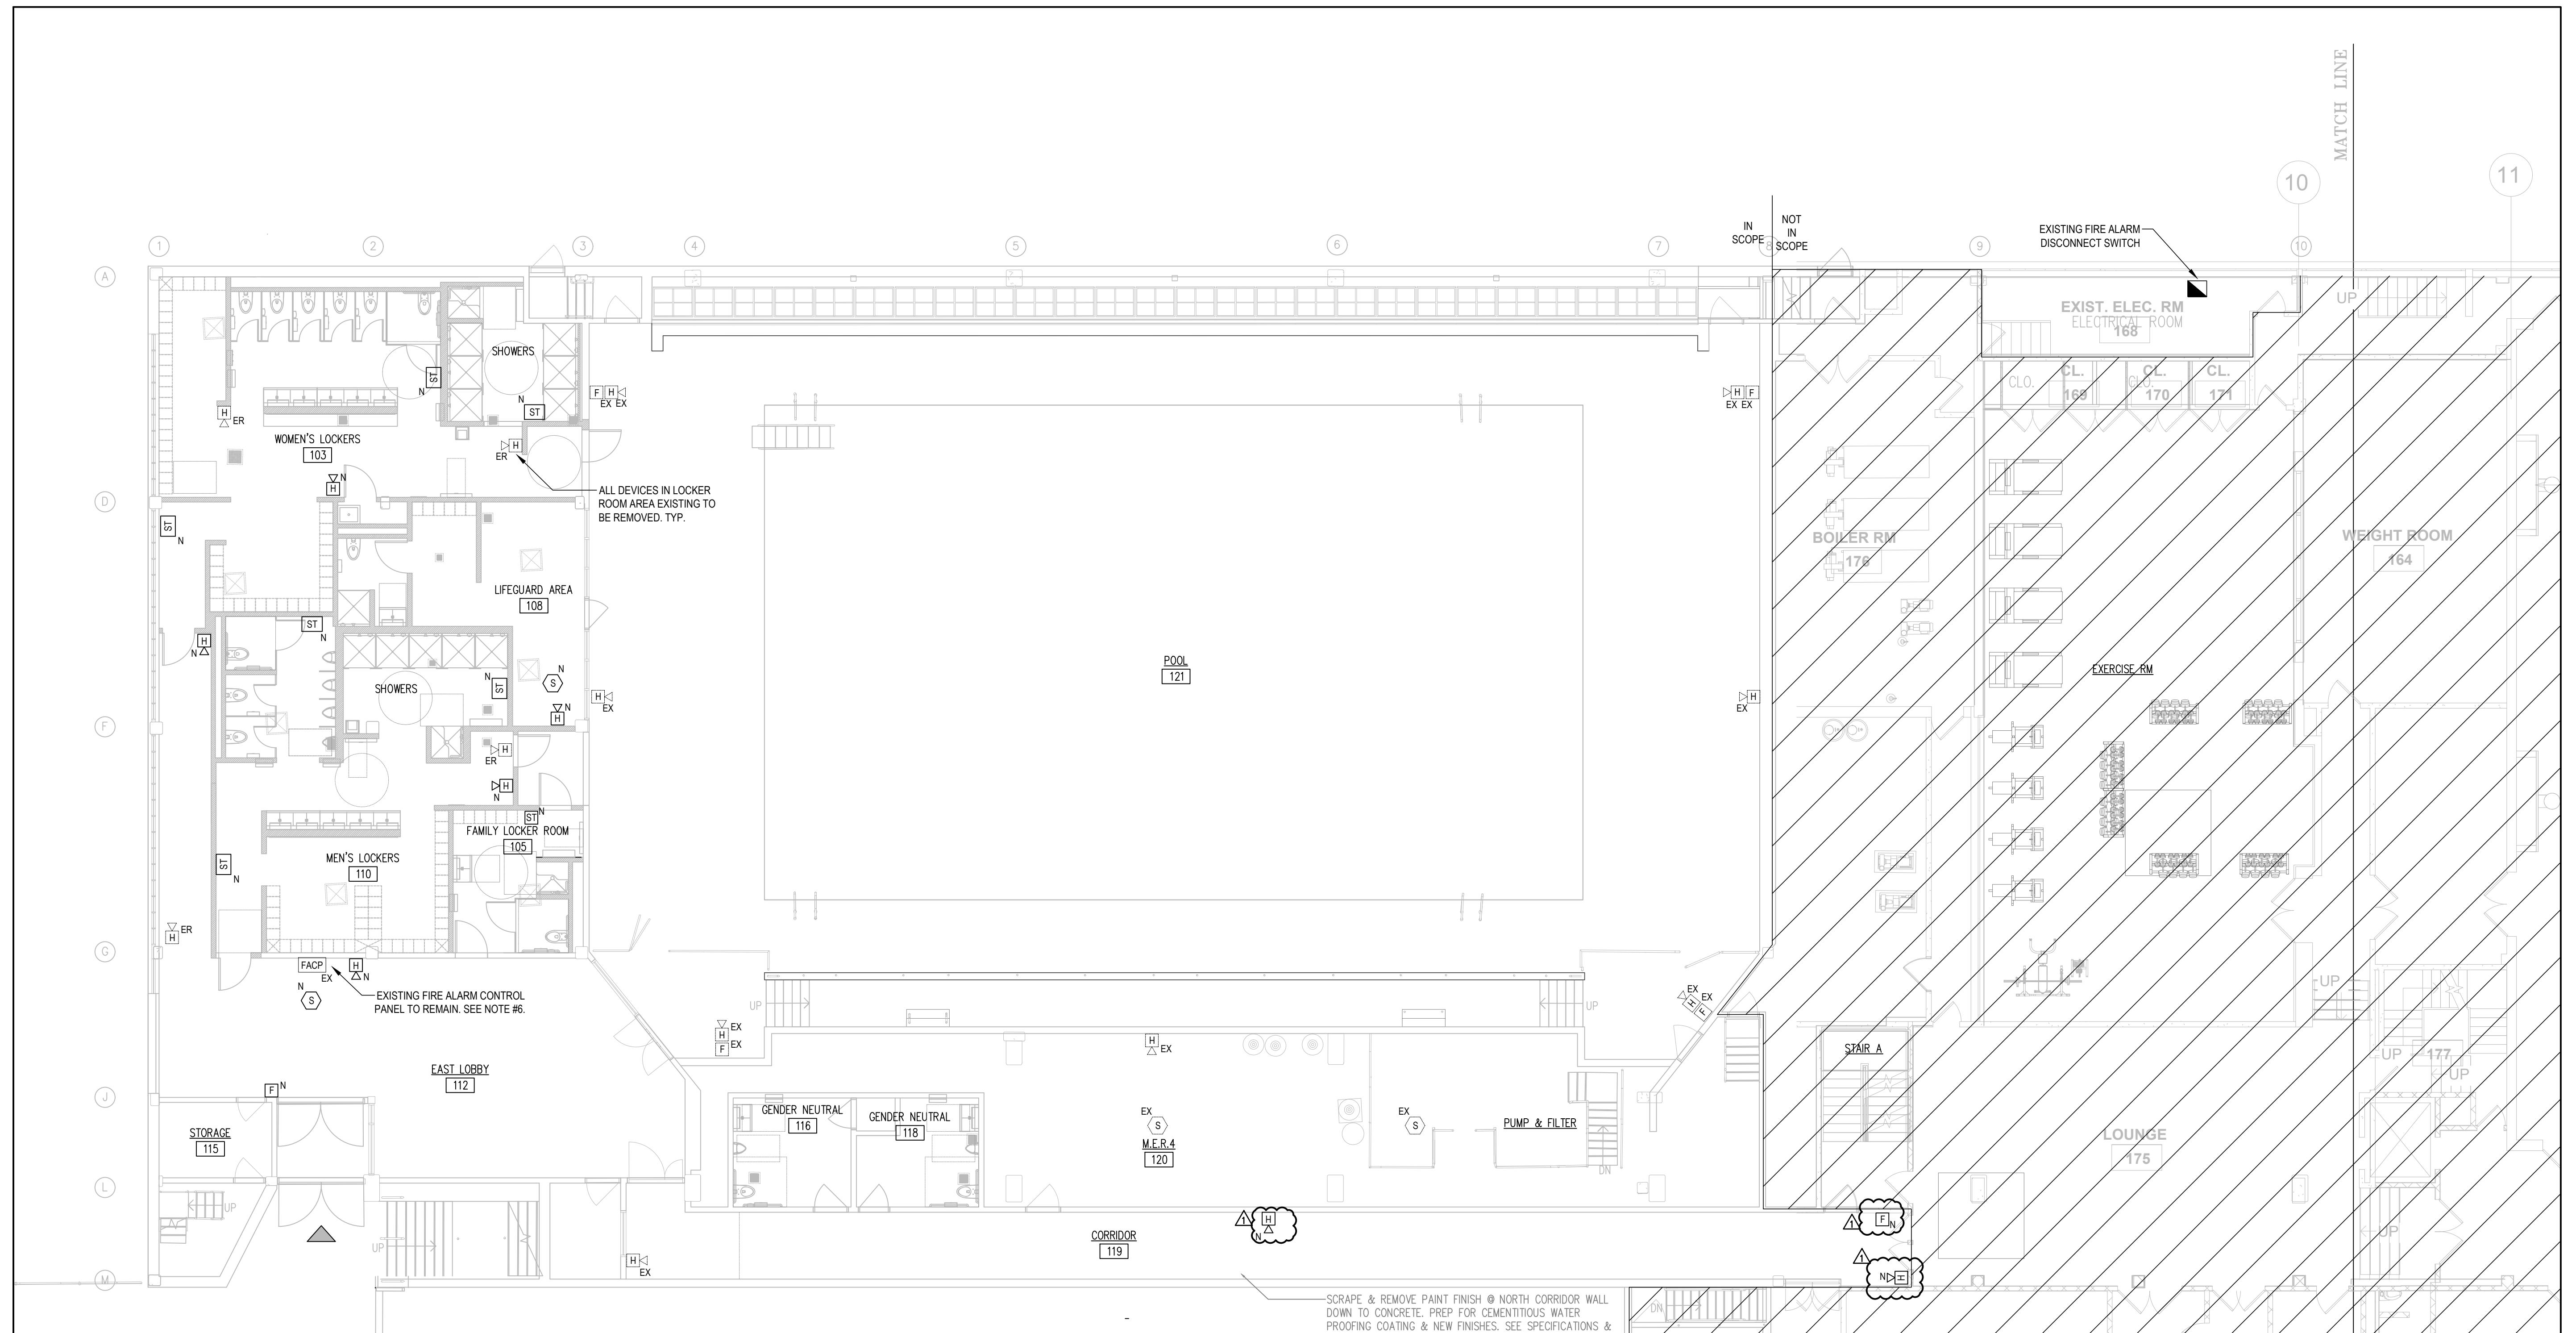
ROOSEVELT ISLAND-
SPORTSPARK
RENOVATIONS

250 Main St.
Roosevelt Island, NY
10044

DRAWING
FIRE ALARM FIRST FLOOR
EAST PLAN

SEAL & SIGNATURE	DATE	06.10.2019
JOB NUMBER		19010
DWG. No.		FA-100.00
DRAWN BY		MR 2 OF 4

NYC DOB Number



FIRE ALARM NOTES:

1. ALL NEW DEVICES SHALL BE INSTALLED IN THE VICINITY AS DIRECTED BY THE ARCHITECT AND SHALL BE CENTERED ON COLUMNS PER ARCHITECTURAL DRAWINGS.
2. OBTAIN DIMENSIONAL DRAWINGS PRIOR TO ROUGH-IN.
3. CEILING DEVICES MAY BE PROVIDED WHERE APPROVED BY THE CODE OFFICIAL AND FILED DRAWINGS/DOCUMENTS.
4. PERFORM DISCONNECTION OF EXISTING DEVICES WHEN DIRECTED BY THE FA VENDOR. PROTECT DURING CONSTRUCTION.
5. ER DESIGNATED DEVICES ARE EXISTING TO BE REMOVED.
6. FIRE ALARM CONTROL PANEL WAS INSTALLED UNDER PREVIOUSLY APPROVED APPLICATION. REFER TO FA-001.00 FOR LETTER OF APPROVAL INFORMATION.
7. COORDINATE ALL FSD'S WITH MECHANICAL DRAWINGS.
8. IT SHOULD BE KNOWN THAT THE FIRE ALARM DEVICES SHOWN ARE REQUIRED BY CODE AND THERE MAYBE INSTANCES WHERE A NEW DEVICE IS SHOWN AND THERE IS AN EXISTING DEVICE ALREADY IN PLACE OR LOCATED IN ROOM OR WITHIN THE VICINITY OF NEW DEVICE. CONTRACTOR SHALL FIELD VERIFY CONDITIONS PRIOR TO INSTALLATION AND SHALL PROVIDE AS PART OF THEIR BID A UNIT PRICE PER DEVICE SO THAT IN AN EVENT THAT THE DEVICES ARE TO BE ADDED OR DELETED WHEN THERE IS A COST ALREADY IN PLACE FOR THIS WORK.

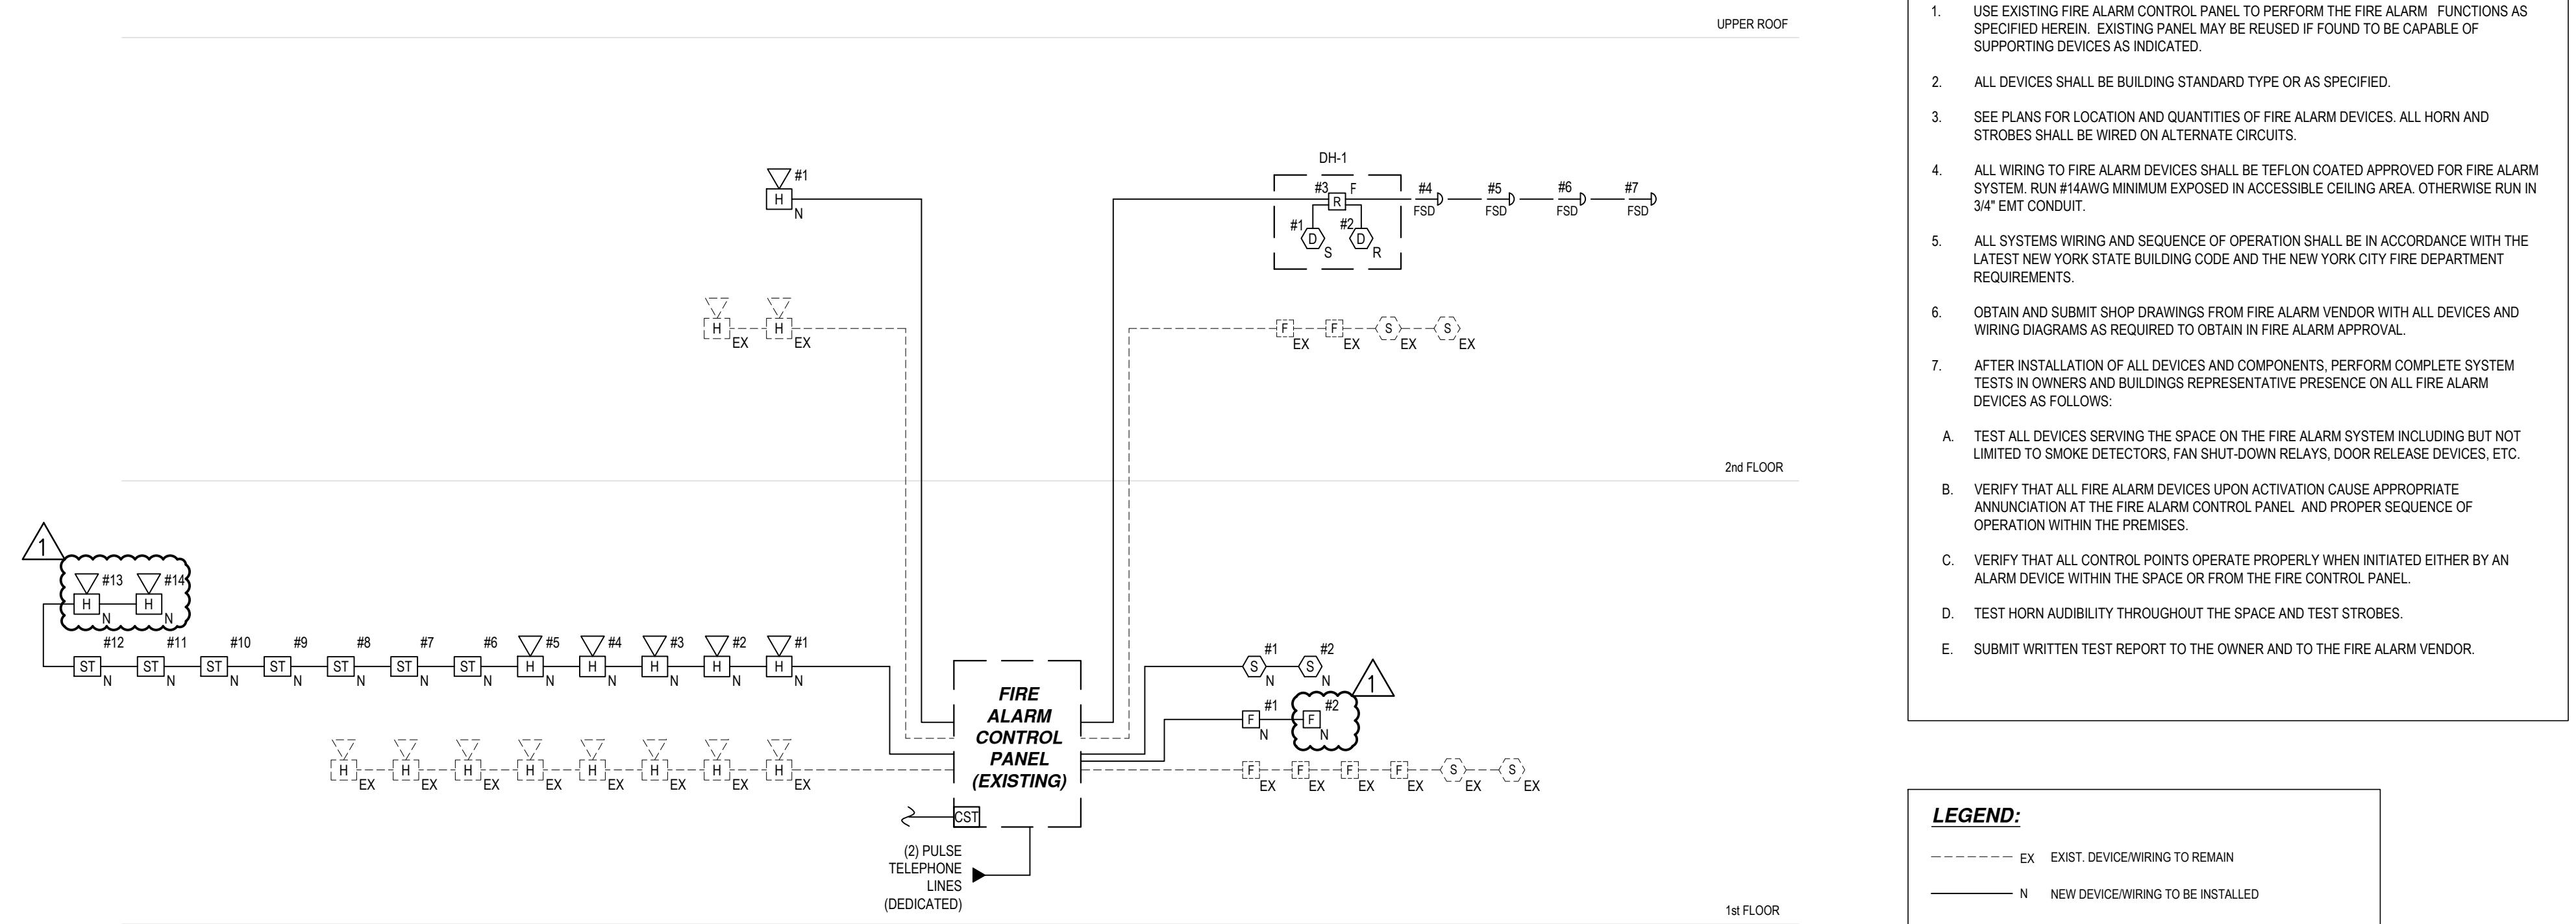
1 FIRE ALARM FIRST FLOOR EAST PLAN
FA-100.00
SCALE: 1/8"=1'-0"

UNAUTHORIZED ALTERATION OF ADDITION TO THIS DOCUMENT IS A VIOLATION OF SECTION 7209 OF THE NEW YORK STATE EDUCATION LAW.
THE CONTRACTOR FOR THE PROJECT (HEREOF) PREPARED BY OR BEARING THE SEAL OF THE
ENGINEER, SHALL NOT BE REUSED FOR ANY EXTENSIONS OF THE PROJECT OR ANY OTHER
PROJECT WITHOUT THE WRITTEN CONSENT OF THE ENGINEER.

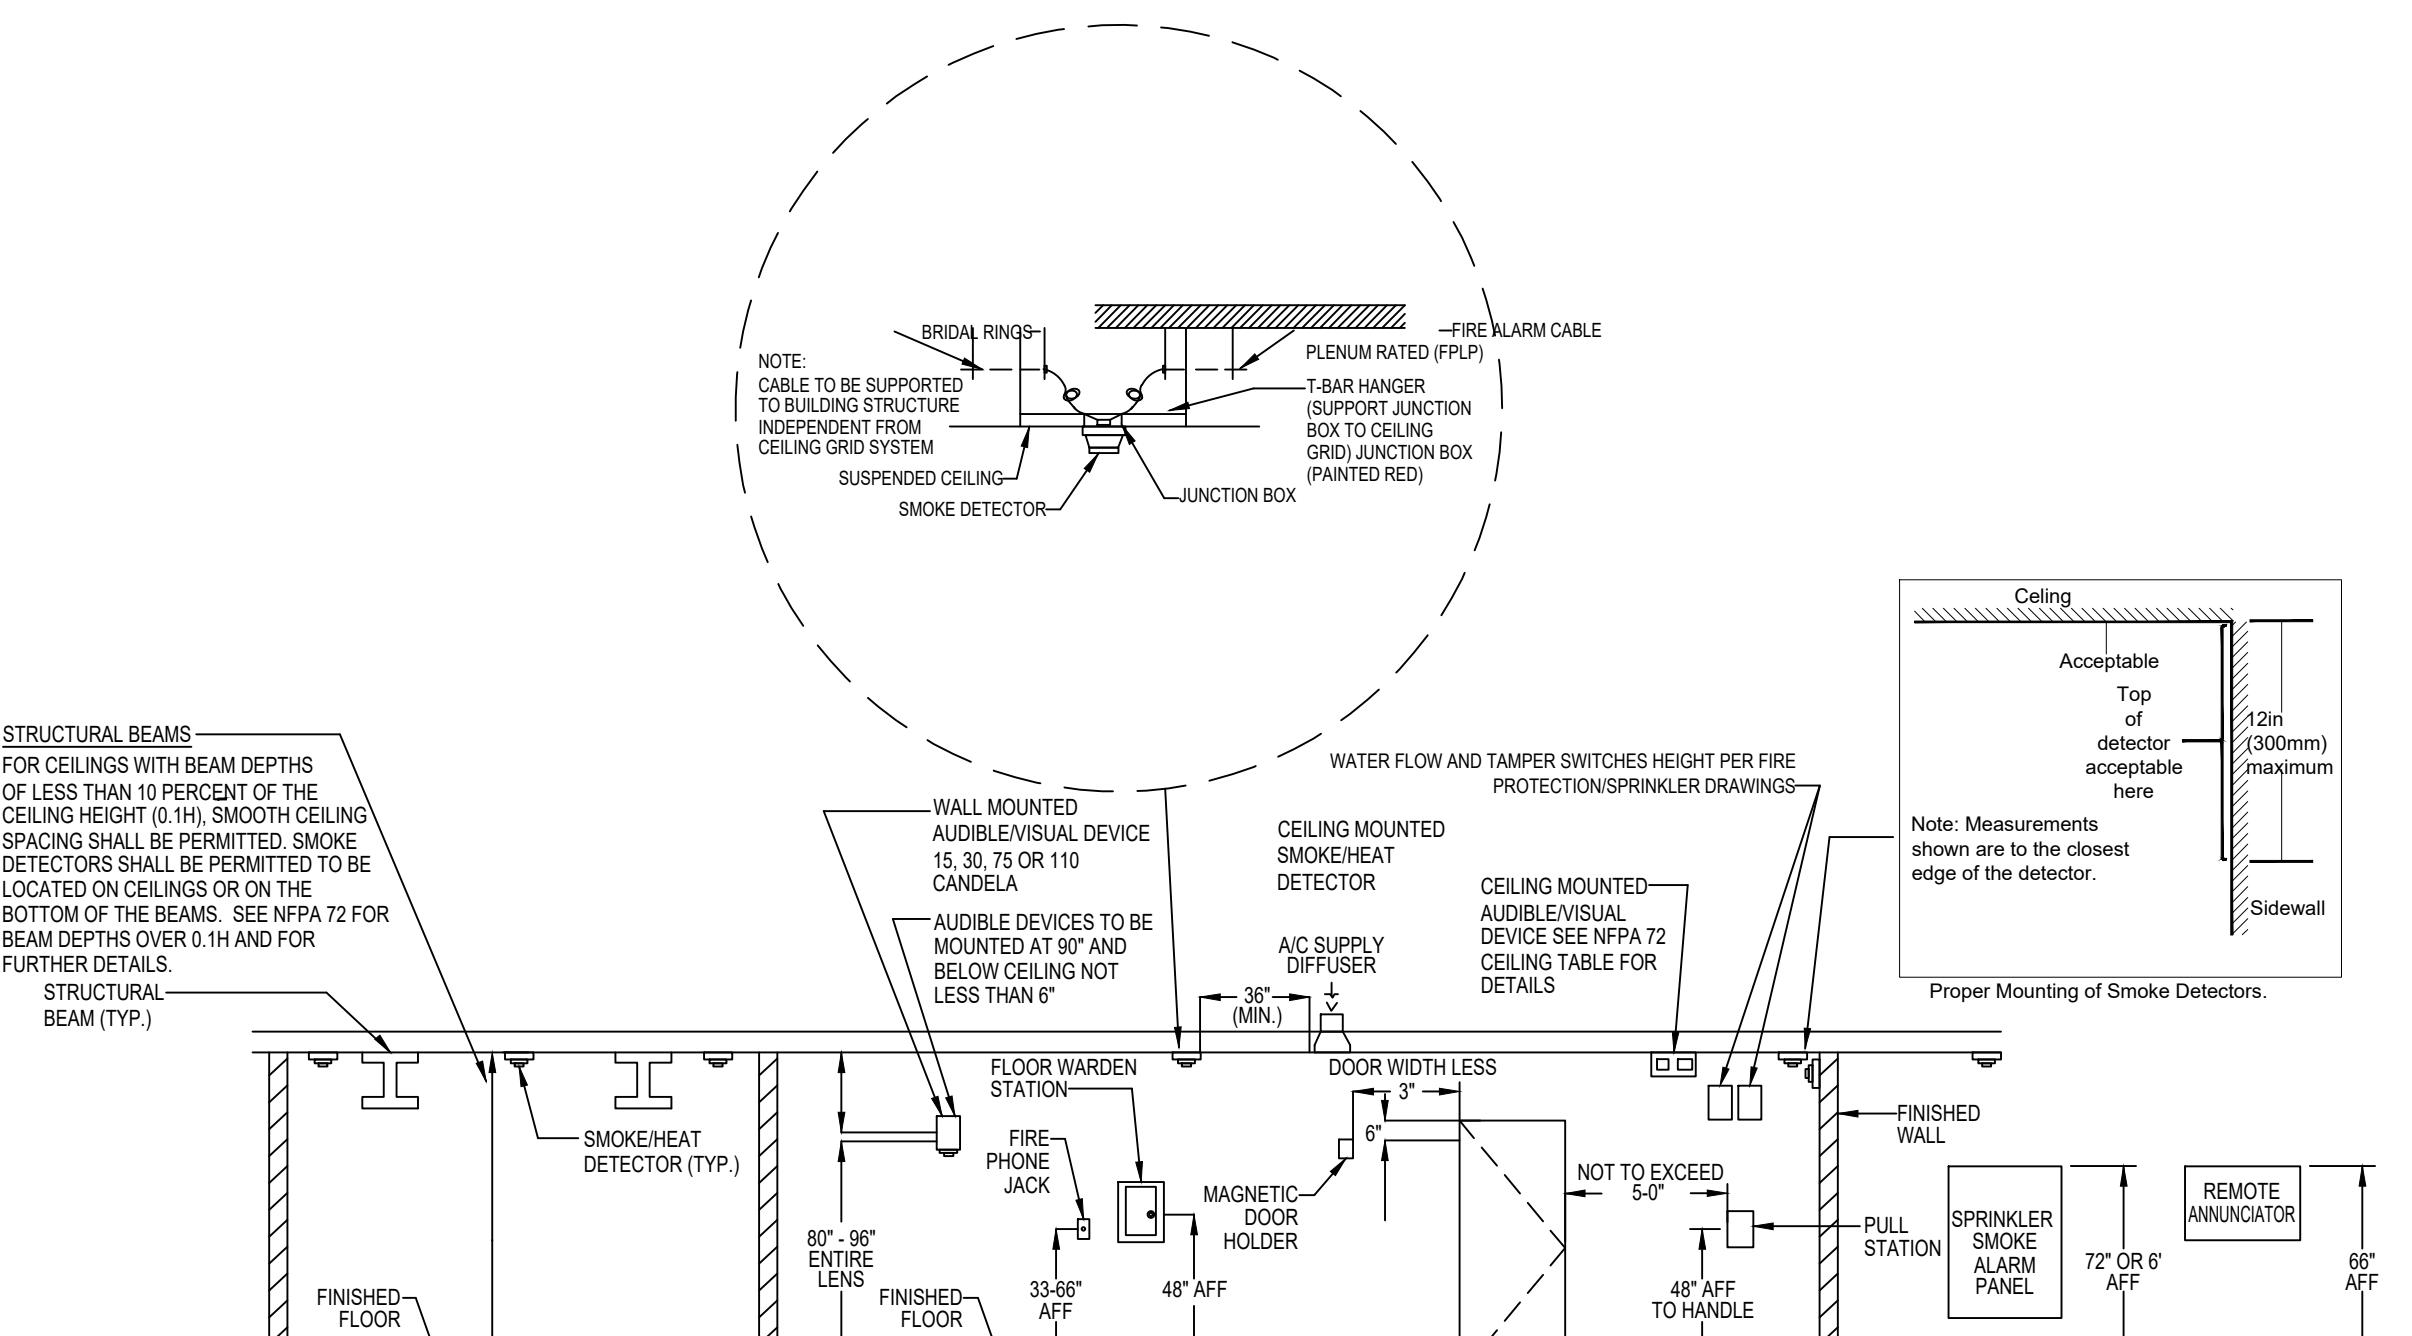

D.O.B. DISCLAIMER:

THIS PLAN IS APPROVED ONLY FOR WORK INDICATED ON THE APPLICATION SPECIFICATION SHEET. ALL OTHER MATTERS SHOWN ARE NOT TO BE RELIED UPON, OR TO BE CONSIDERED AS EITHER BEING APPROVED OR IN ACCORDANCE WITH APPLICABLE CODES.

5	02.16.21	ADDENDUM #1
4	01.29.21	ISSUED FOR 100% CD
3	04.03.20	BID SET
2	10.07.19	100% SUBMISSION - ISSUED FOR BID
1	09.20.19	90% SUBMISSION - ISSUED FOR BID
NO.	DATE	DESCRIPTION
		ISSUE / REVISION


APPROVED CLASS 'TEMPORAL 3' SYSTEM- FIRE ALARM RISER DIAGRAM

N.T.S.


STANDARD FIRE ALARM DEVICE MOUNTING HEIGHTS

NOTE:
1. REFER TO FLOOR PLANS FOR LOCATIONS.
2. ALL FINAL MOUNTING HEIGHT MUST COMPLY WITH NFPA 72 AND AUTHORITY HAVING JURISDICTION.
3. ALL INSTALLATION TO BE IN ACCORDANCE WITH MFG. RECOMMENDATIONS AND AS PER APPROVED SHOP DRAWINGS.
4. MOUNTING HEIGHTS ARE SHOWN FOR COMPLIANCE WITH NFPA 72. NOT ALL DEVICES SHOWN ARE APPLICABLE TO THIS PROJECT.

		MANUAL/AUTOMATIC FIRE ALARM SYSTEM												NOTIFICATION						FIRE SAFETY CONTROL													
		FIRE ALARM PANEL						ANNUN.			NOTIFICATION						FIRE SAFETY CONTROL																
A	B	C	D	E	F	G	H	I	J	K	L	M	N	O	P	Q	R	S	T	U	V	W	X	Y	Z	AA	BB	CC	DD	EE	FF	GG	
1	MANUAL PULLSTATION	●						●										●								●							1
2	AREA SMOKE DETECTOR	●						●										●								●							2
3	DUCT SMOKE DETECTOR	●						●										●								●							3
4	HEAT DETECTOR	●						●										●								●							4
																																5	
																																6	
																																7	
1	OPEN CIRCUIT	●						●																									1
2	GROUNDED WIRE	●						●																									2
3	A/C FAILURE	●						●																								3	
4	BATTERY FAULT	●						●																								4	
5	WIRE TO WIRE SHORT	●						●										●														5	

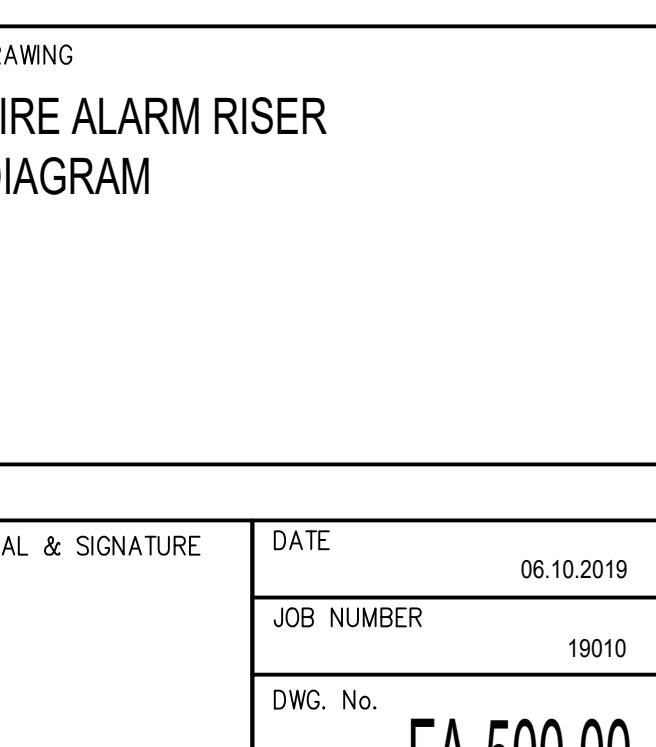
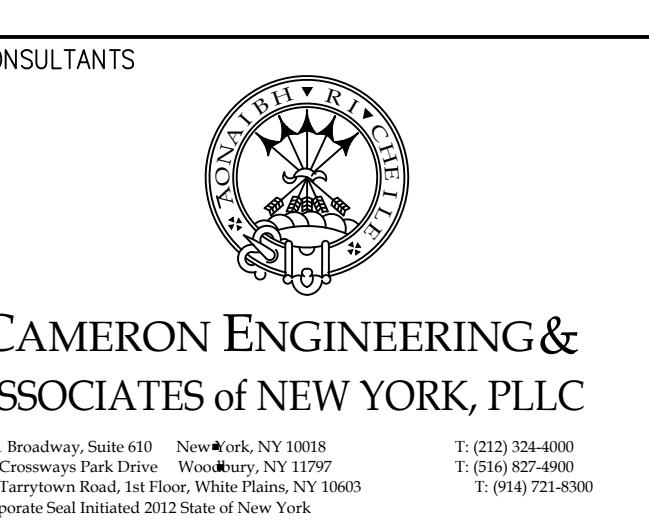
EXISTING BUILDING TEMPORAL '3' FA SYSTEM MATRIX

NOTE:																													
1. REFER TO FLOOR PLANS FOR LOCATIONS.																													
2. ALL FINAL MOUNTING HEIGHT MUST COMPLY WITH NFPA 72 AND AUTHORITY HAVING JURISDICTION.																													
3. ALL INSTALLATION TO BE IN ACCORDANCE WITH MFG. RECOMMENDATIONS AND AS PER APPROVED SHOP DRAWINGS.																													
4. MOUNTING HEIGHTS ARE SHOWN FOR COMPLIANCE WITH NFPA 72. NOT ALL DEVICES SHOWN ARE APPLICABLE TO THIS PROJECT.																													

UNAUTHORIZED ALTERATION OF ADDITION TO THIS DOCUMENT IS A VIOLATION OF SECTION 7209 OF THE NEW YORK STATE EDUCATION LAW.
THIS DOCUMENT IS THE PROPERTY OF THE PROJECT OWNER. ANYONE WHO MAKES A COPY THEREOF PREPARED BY OR BEARING THE SEAL OF THE ENGINEER, SHALL NOT BE REUSED FOR ANY EXTENSIONS OF THE PROJECT OR ANY OTHER PROJECT WITHOUT THE WRITTEN CONSENT OF THE ENGINEER.

NYC DOB Number

SEAL & SIGNATURE	DATE	06.10.2019
JOB NUMBER	19010	
DWG. No.	FA-500.00	
DRAWN BY	MR	4 OF 4

ARCHITECT


NYC DOB Number