


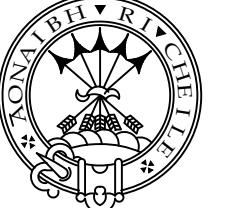

D.O.B. DISCLAIMER:  
THIS PLAN IS APPROVED ONLY FOR WORK INDICATED ON THE APPLICATION SPECIFICATION SHEET. ALL OTHER MATTERS SHOWN ARE NOT TO BE RELIED UPON, OR TO BE CONSIDERED AS EITHER BEING APPROVED OR IN ACCORDANCE WITH APPLICABLE CODES.

5 02.16.21 ADDENDUM #1 △  
4 01.29.21 ISSUED FOR 100% CD  
3 01.12.21 ISSUED FOR FILING  
2 01.08.21 ISSUED FOR OWNER'S REVIEW  
1 08.10.20 50% SUBMISSION  
NO. DATE DESCRIPTION  
ISSUE / REVISION

JDA  
June Daniel Architect PLLC  
64 Hilton Avenue  
Hempstead, New York 11550  
Tel. 516.414.6737  
ARCHITECT


CONSULTANTS  
  
CAMERON ENGINEERING & ASSOCIATES OF NEW YORK, PLLC  
1411 Broadway, Suite 610 New York, NY 10018  
177 Crossways Park Drive Woodbury, NY 11797  
Corporate Seal Initiated 2012 State of New York  
www.CameronEngineering.com  
T: (212) 324-4000  
F: (516) 827-4000  
E: (914) 721-8700  
COPYRIGHT


PROJECT  
ROOSEVELT ISLAND-  
SPORTSPARK  
RENOVATIONS  
PHASE #3  
250 Main St.  
Roosevelt Island, NY  
10044

DRAWING  
FIRE ALARM FIRST FLOOR  
EAST PLAN

SEAL & SIGNATURE DATE 08.10.2019  
JOB NUMBER 19010  
DWG. No. FA-100.00  
DRAWN BY D.M. 3 OF 6

NYC DOB Number

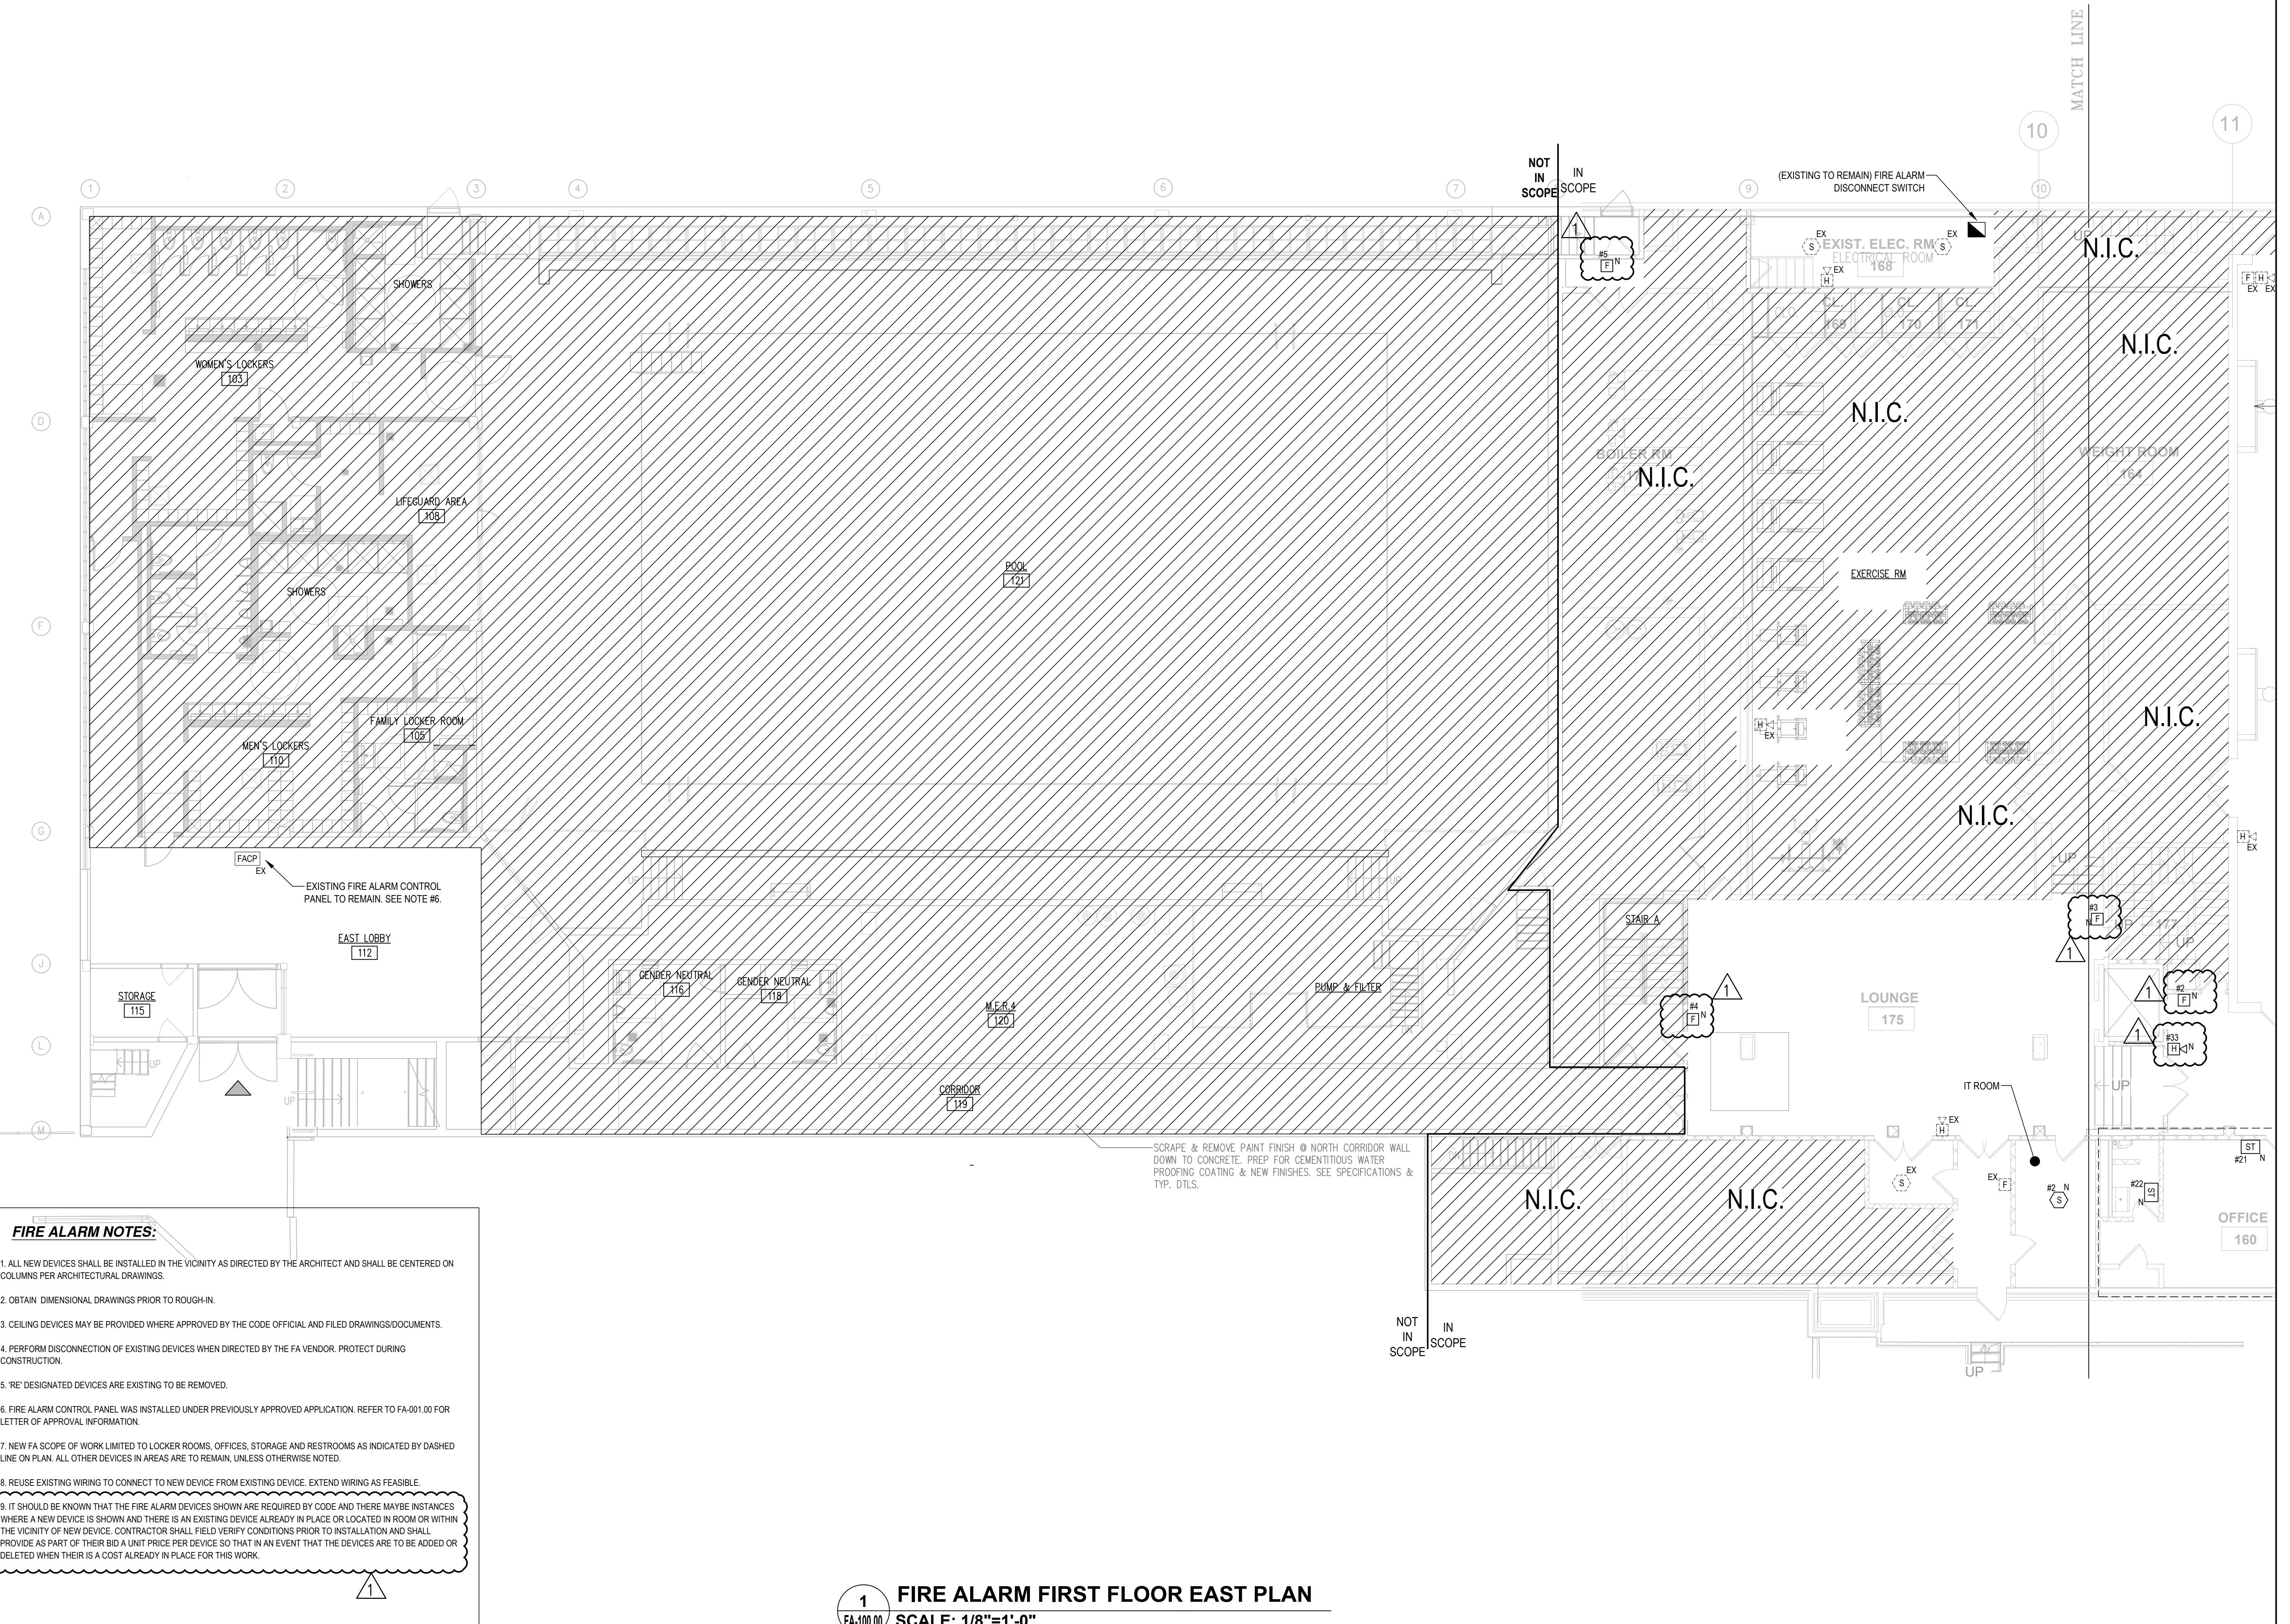

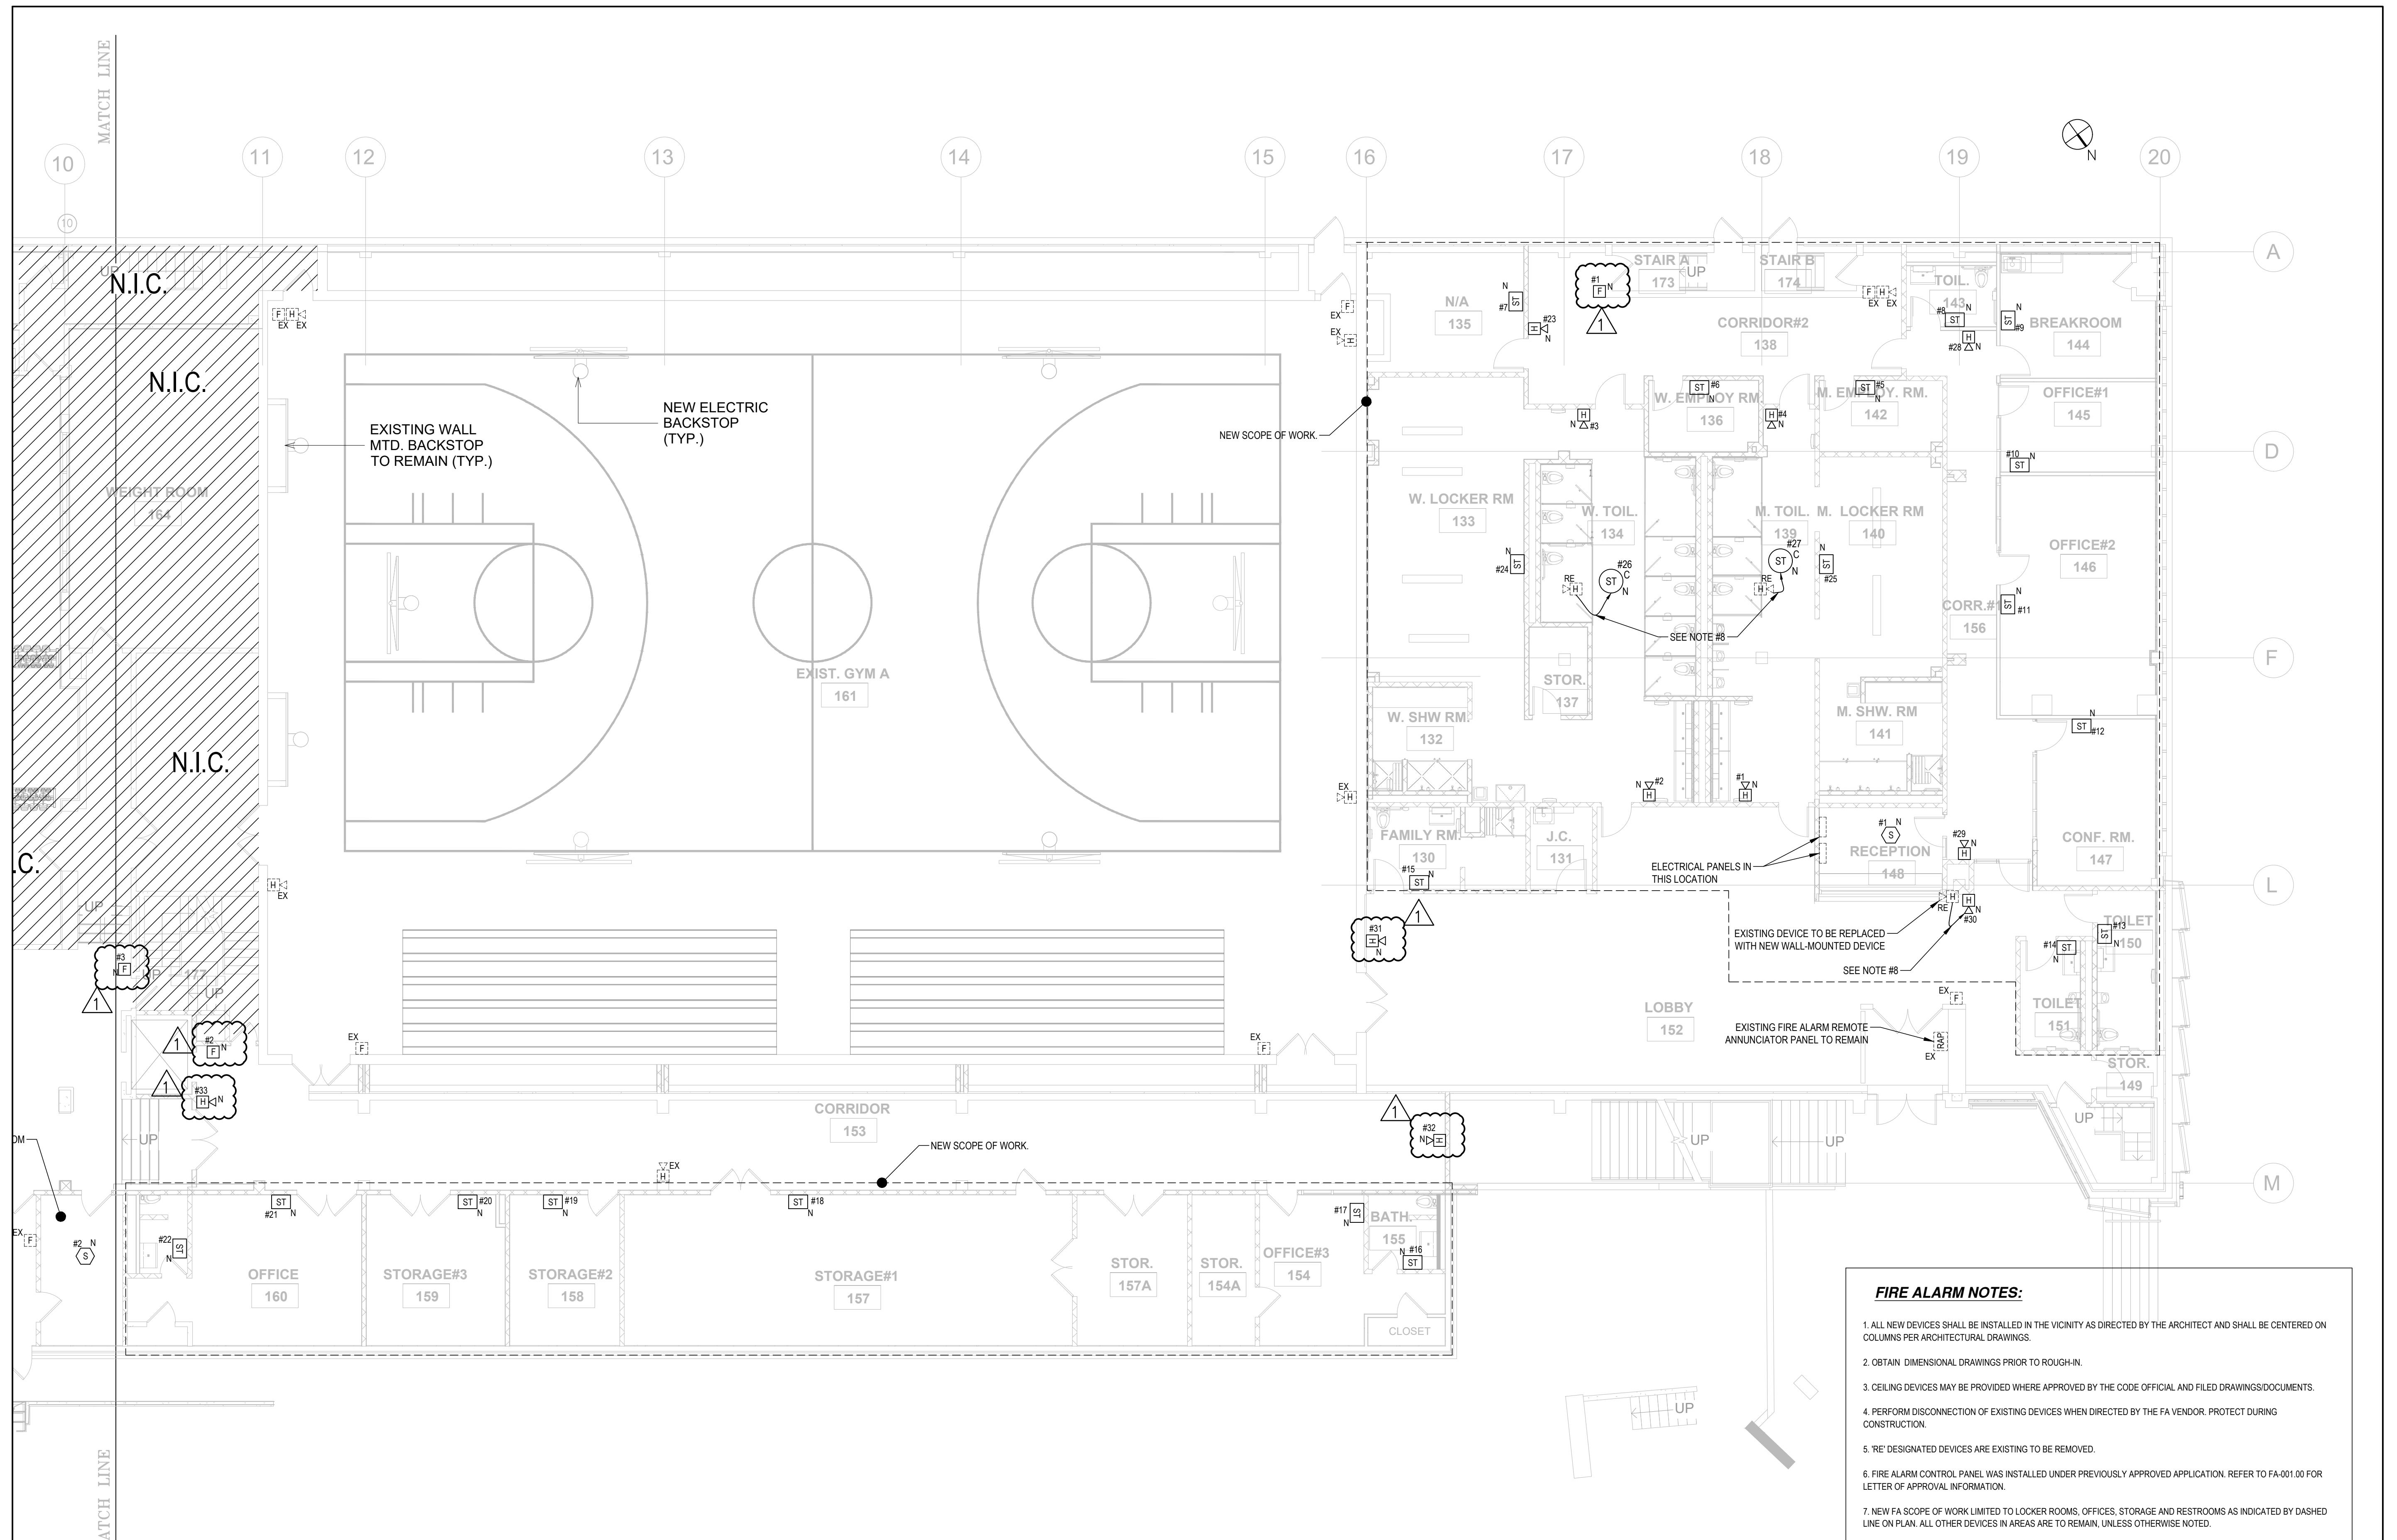

**D.O.B. DISCLAIMER:**  
THIS PLAN IS APPROVED ONLY FOR WORK INDICATED ON THE APPLICATION SPECIFICATION SHEET. ALL OTHER MATTERS SHOWN ARE NOT TO BE RELIED UPON OR TO BE CONSIDERED AS EITHER BEING APPROVED OR IN ACCORDANCE WITH APPLICABLE CODES.

5 02.16.21 ADDENDUM #1 ▲  
4 01.29.21 ISSUED FOR 100% CD  
3 01.12.21 ISSUED FOR FILING  
2 01.08.21 ISSUED FOR OWNER'S REVIEW  
1 08.10.20 50% SUBMISSION  
NO. DATE DESCRIPTION  
ISSUE / REVISION

**JDA**  
June Daniel Architect PLLC  
64 Hilton Avenue  
Hempstead, New York 11550  
Tel. 516.414.6737

**CONSULTANTS**  
  
**CAMERON ENGINEERING & ASSOCIATES OF NEW YORK, PLLC**  
1411 Broadway, Suite 610 New York, NY 10018  
177 Crossways Park Drive Woodbury, NY 11797  
Corporate Seal Initiated 2012 State of New York  
www.CameronEngineering.com  
T: (212) 324-4000  
F: (516) 827-4000  
E: (914) 721-8900  
COPYRIGHT

**PROJECT**  
**ROOSEVELT ISLAND-SPORTSPARK RENOVATIONS PHASE #3**  
250 Main St.  
Roosevelt Island, NY  
10044

**DRAWING**  
**FIRE ALARM FIRST FLOOR WEST PLAN**

**FIRE ALARM NOTES:**

1. ALL NEW DEVICES SHALL BE INSTALLED IN THE VICINITY AS DIRECTED BY THE ARCHITECT AND SHALL BE CENTERED ON COLUMNS PER ARCHITECTURAL DRAWINGS.
2. CEILING DIMENSIONAL DRAWINGS PRIOR TO ROUGH-IN.
3. CEILING DEVICES MAY BE PROVIDED WHERE APPROVED BY THE CODE OFFICIAL AND FILED DRAWINGS/DOCUMENTS.
4. PERFORM DISCONNECTION OF EXISTING DEVICES WHEN DIRECTED BY THE FA VENDOR. PROTECT DURING CONSTRUCTION.
5. 'RE' DESIGNATED DEVICES ARE EXISTING TO BE REMOVED.
6. FIRE ALARM CONTROL PANEL WAS INSTALLED UNDER PREVIOUSLY APPROVED APPLICATION. REFER TO FA-001.00 FOR LETTER OF APPROVAL INFORMATION.
7. NEW FA SCOPE OF WORK LIMITED TO LOCKER ROOMS, OFFICES, STORAGE AND RESTROOMS AS INDICATED BY DASHED LINE ON PLAN. ALL OTHER DEVICES IN AREAS ARE TO REMAIN, UNLESS OTHERWISE NOTED.
8. REUSE EXISTING WIRING TO CONNECT TO NEW DEVICE FROM EXISTING DEVICE. EXTEND WIRING AS FEASIBLE.
9. IT SHOULD BE KNOWN THAT THE FIRE ALARM DEVICES SHOWN ARE REQUIRED BY CODE AND THERE MAYBE INSTANCES WHERE A NEW DEVICE IS SHOWN AND THERE IS AN EXISTING DEVICE ALREADY IN PLACE OR LOCATED IN ROOM OR WITHIN THE VICINITY OF NEW DEVICE. CONTRACTOR SHALL FIELD VERIFY CONDITIONS PRIOR TO INSTALLATION AND SHALL PROVIDE AS PART OF THEIR BID A UNIT PRICE PER DEVICE SO THAT IN AN EVENT THAT THE DEVICES ARE TO BE ADDED OR DELETED WHEN THERE IS A COST ALREADY IN PLACE FOR THIS WORK.

UNAUTHORIZED ALTERATION OF ADDITION TO THIS DOCUMENT IS A VIOLATION OF SECTION 7209 OF THE NEW YORK STATE EDUCATION LAW.  
THE ENGINEER FOR THIS PROJECT (HEREOF) PREPARED BY OR BEARING THE SEAL OF THE  
ENGINEER, SHALL NOT BE REUSED FOR ANY EXTENSIONS OF THE PROJECT OR ANY OTHER  
PROJECT WITHOUT THE WRITTEN CONSENT OF THE ENGINEER.

**SEAL & SIGNATURE** **DATE** 06.10.2019  
**JOB NUMBER** 19010  
**DWG. No.** FA-101.00  
**DRAWN BY** D.M. **4 OF 6**

**NYC DOB Number**



## D.B. DISCLAIMER


THIS PLAN IS APPROVED ONLY FOR WORK INDICATED ON  
APPLICATION SPECIFICATION SHEET. ALL OTHER  
DIMENSIONS SHOWN ARE NOT TO BE RELIED UPON, OR TO  
BE CONSIDERED AS EITHER BEING APPROVED OR IN  
CONFORMITY WITH APPLICABLE CODES.

DATE	DESCRIPTION
02.16.21	ADDENDUM #1 ▲ 1
01.29.21	ISSUED FOR 100% CD
01.12.21	ISSUED FOR FILING
01.08.21	ISSUED FOR OWNER'S REVIEW
08.10.20	50% SUBMISSION

DA

June Daniel Architect PLLC  
21 Hilton Avenue  
Levittown, New York 11550  
(516) 414-6737

## ARCHITECT

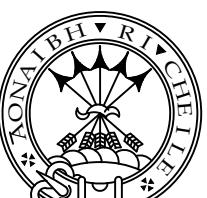

CAMERON ENGINEERING &  
ASSOCIATES of NEW YORK, PLLC

Broadway, Suite 610 New York, NY 10018 T: (212) 324-4000  
Crossways Park Drive Woodbury, NY 11797 T: (516) 827-4900  
Tarrytown Road, 1st Floor, White Plains, NY 10603 T: (914) 721-8300  
© 2012 Carl Schlueter, 2012 State of New York

Corporate Seal Initiated 2012 State of New York  
[www.Cameronengineering.com](http://www.Cameronengineering.com) COPYRIGHT



JECT

# ROOSEVELT ISLAND- SPORTSPARK RENOVATIONS PHASE #3

250 Main St.  
Roosevelt Island, NY  
10044

## AWING

# IRE ALARM SECOND LOOR EAST PLAN

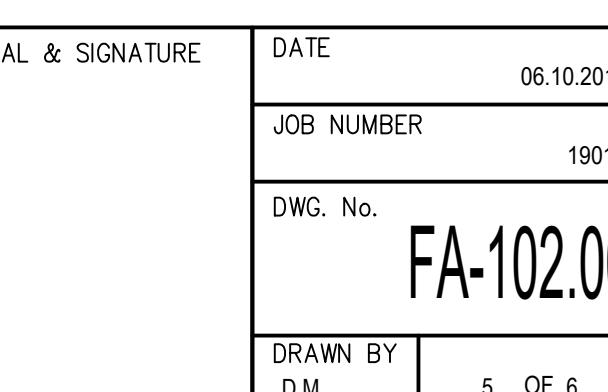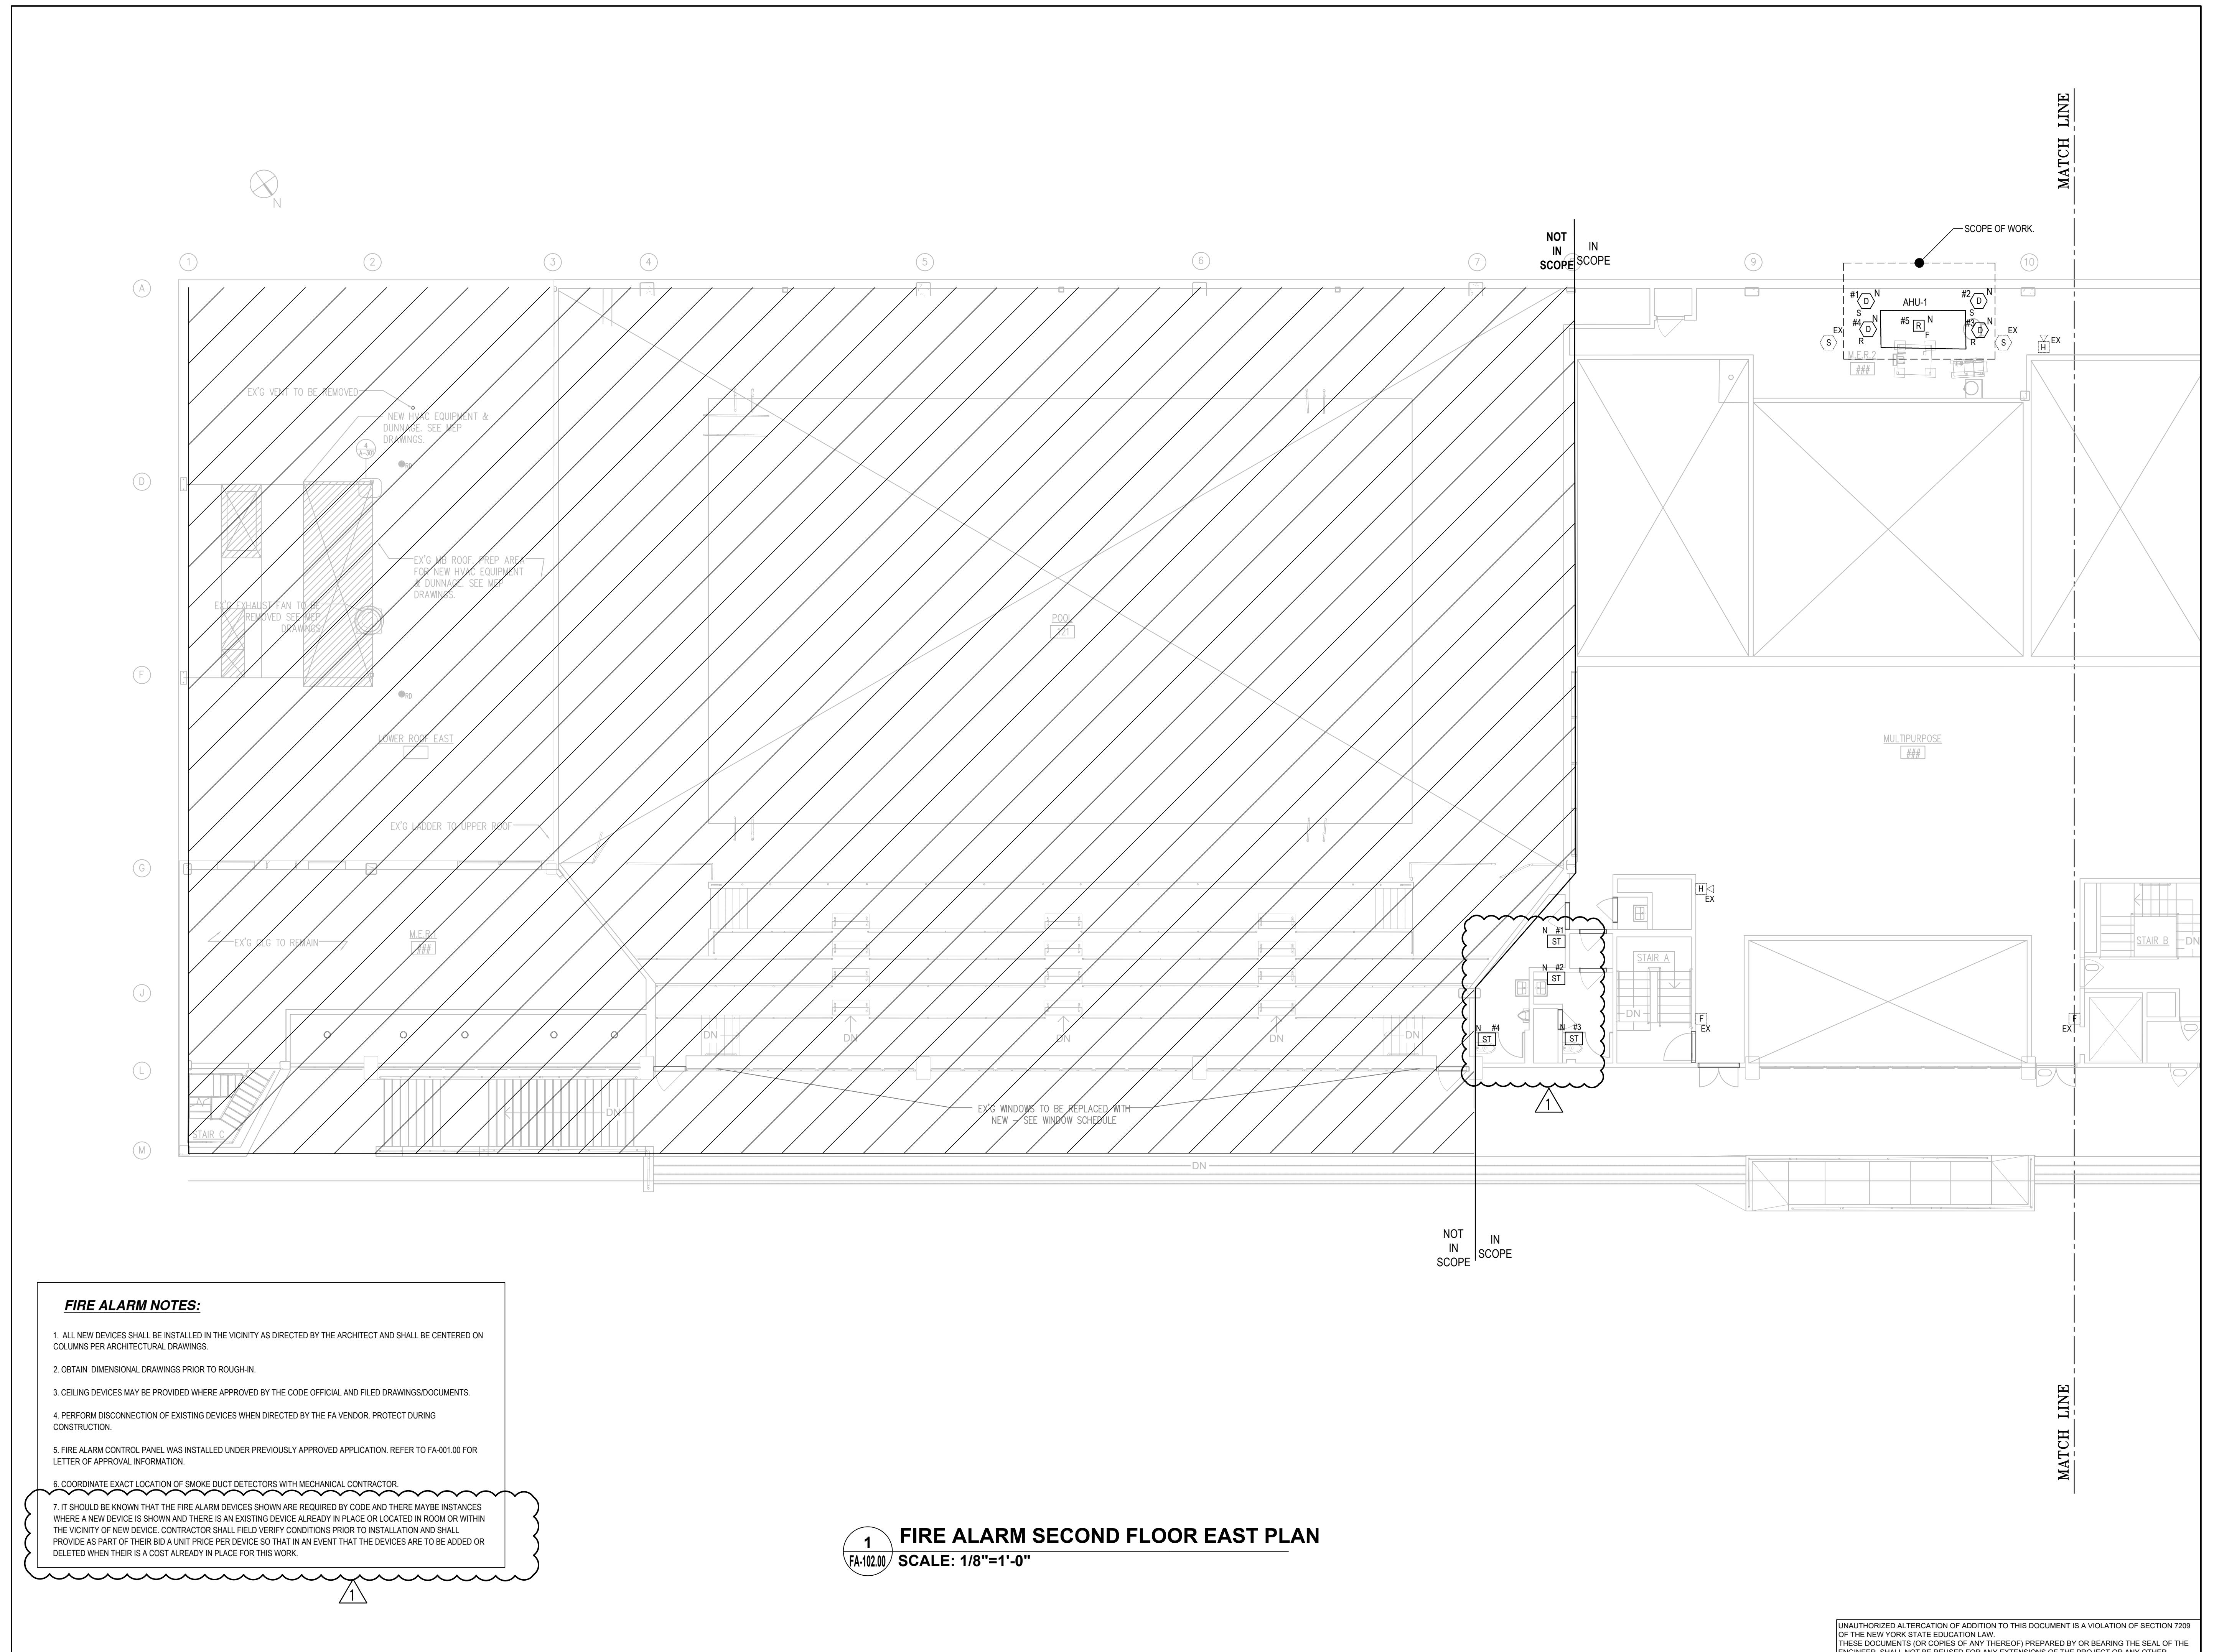

C DOB Number

UTHORIZED ALTERATION OF ADDITION TO THIS DOCUMENT IS A VIOLATION OF SECTION 7209  
HE NEW YORK STATE EDUCATION LAW.  
SE DOCUMENTS (OR COPIES OF ANY THEREOF) PREPARED BY OR BEARING THE SEAL OF THE  
NEER, SHALL NOT BE REUSED FOR ANY EXTENSIONS OF THE PROJECT OR ANY OTHER  
JECT WITHOUT THE WRITTEN CONSENT OF THE ENGINEER.



ROOSEVELT ISLAND  
OPERATING CORP.

D.O.B. DISCLAIMER:

THIS PLAN IS APPROVED ONLY FOR WORK INDICATED ON THE APPLICATION SPECIFICATION SHEET. ALL OTHER MATTERS SHOWN ARE NOT TO BE RELIED UPON OR TO BE CONSIDERED AS EITHER BEING APPROVED OR IN ACCORDANCE WITH APPLICABLE CODES.

5	02.16.21	ADDENDUM #1
4	01.29.21	ISSUED FOR 100% CD
3	01.12.21	ISSUED FOR FILING
2	01.08.21	ISSUED FOR OWNER'S REVIEW
1	08.10.20	50% SUBMISSION


NO. DATE DESCRIPTION  
ISSUE / REVISION

JDA

June Daniel Architect PLLC  
64 Hilton Avenue  
Hempstead, New York 11550  
Tel. 516.414.6737

ARCHITECT

CONSULTANTS

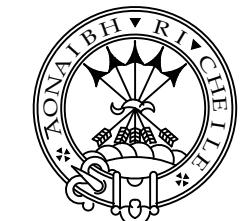

CAMERON ENGINEERING &  
ASSOCIATES OF NEW YORK, PLLC

1411 Broadway, Suite 610 New York, NY 10018  
177 Crossways Park Drive Woodbury, NY 11797  
1000 3rd Avenue, 10th Floor, New York, NY 10020  
Corporate Seal Initiated 2012 State of New York  
www.Cameronengineering.com

T: (212) 324-4000  
T: (516) 827-4000  
F: (914) 721-8300

COPYRIGHT


PROJECT

ROOSEVELT ISLAND-  
SPORTSPARK  
RENOVATIONS  
PHASE #3  
250 Main St.  
Roosevelt Island, NY  
10044

DRAWING  
FIRE ALARM RISER  
DIAGRAM

SEAL & SIGNATURE	DATE	06.10.2019
JOB NUMBER		19010
DWG. No.		FA-500.00
DRAWN BY	D.M.	7 OF 6

NYC DOB Number

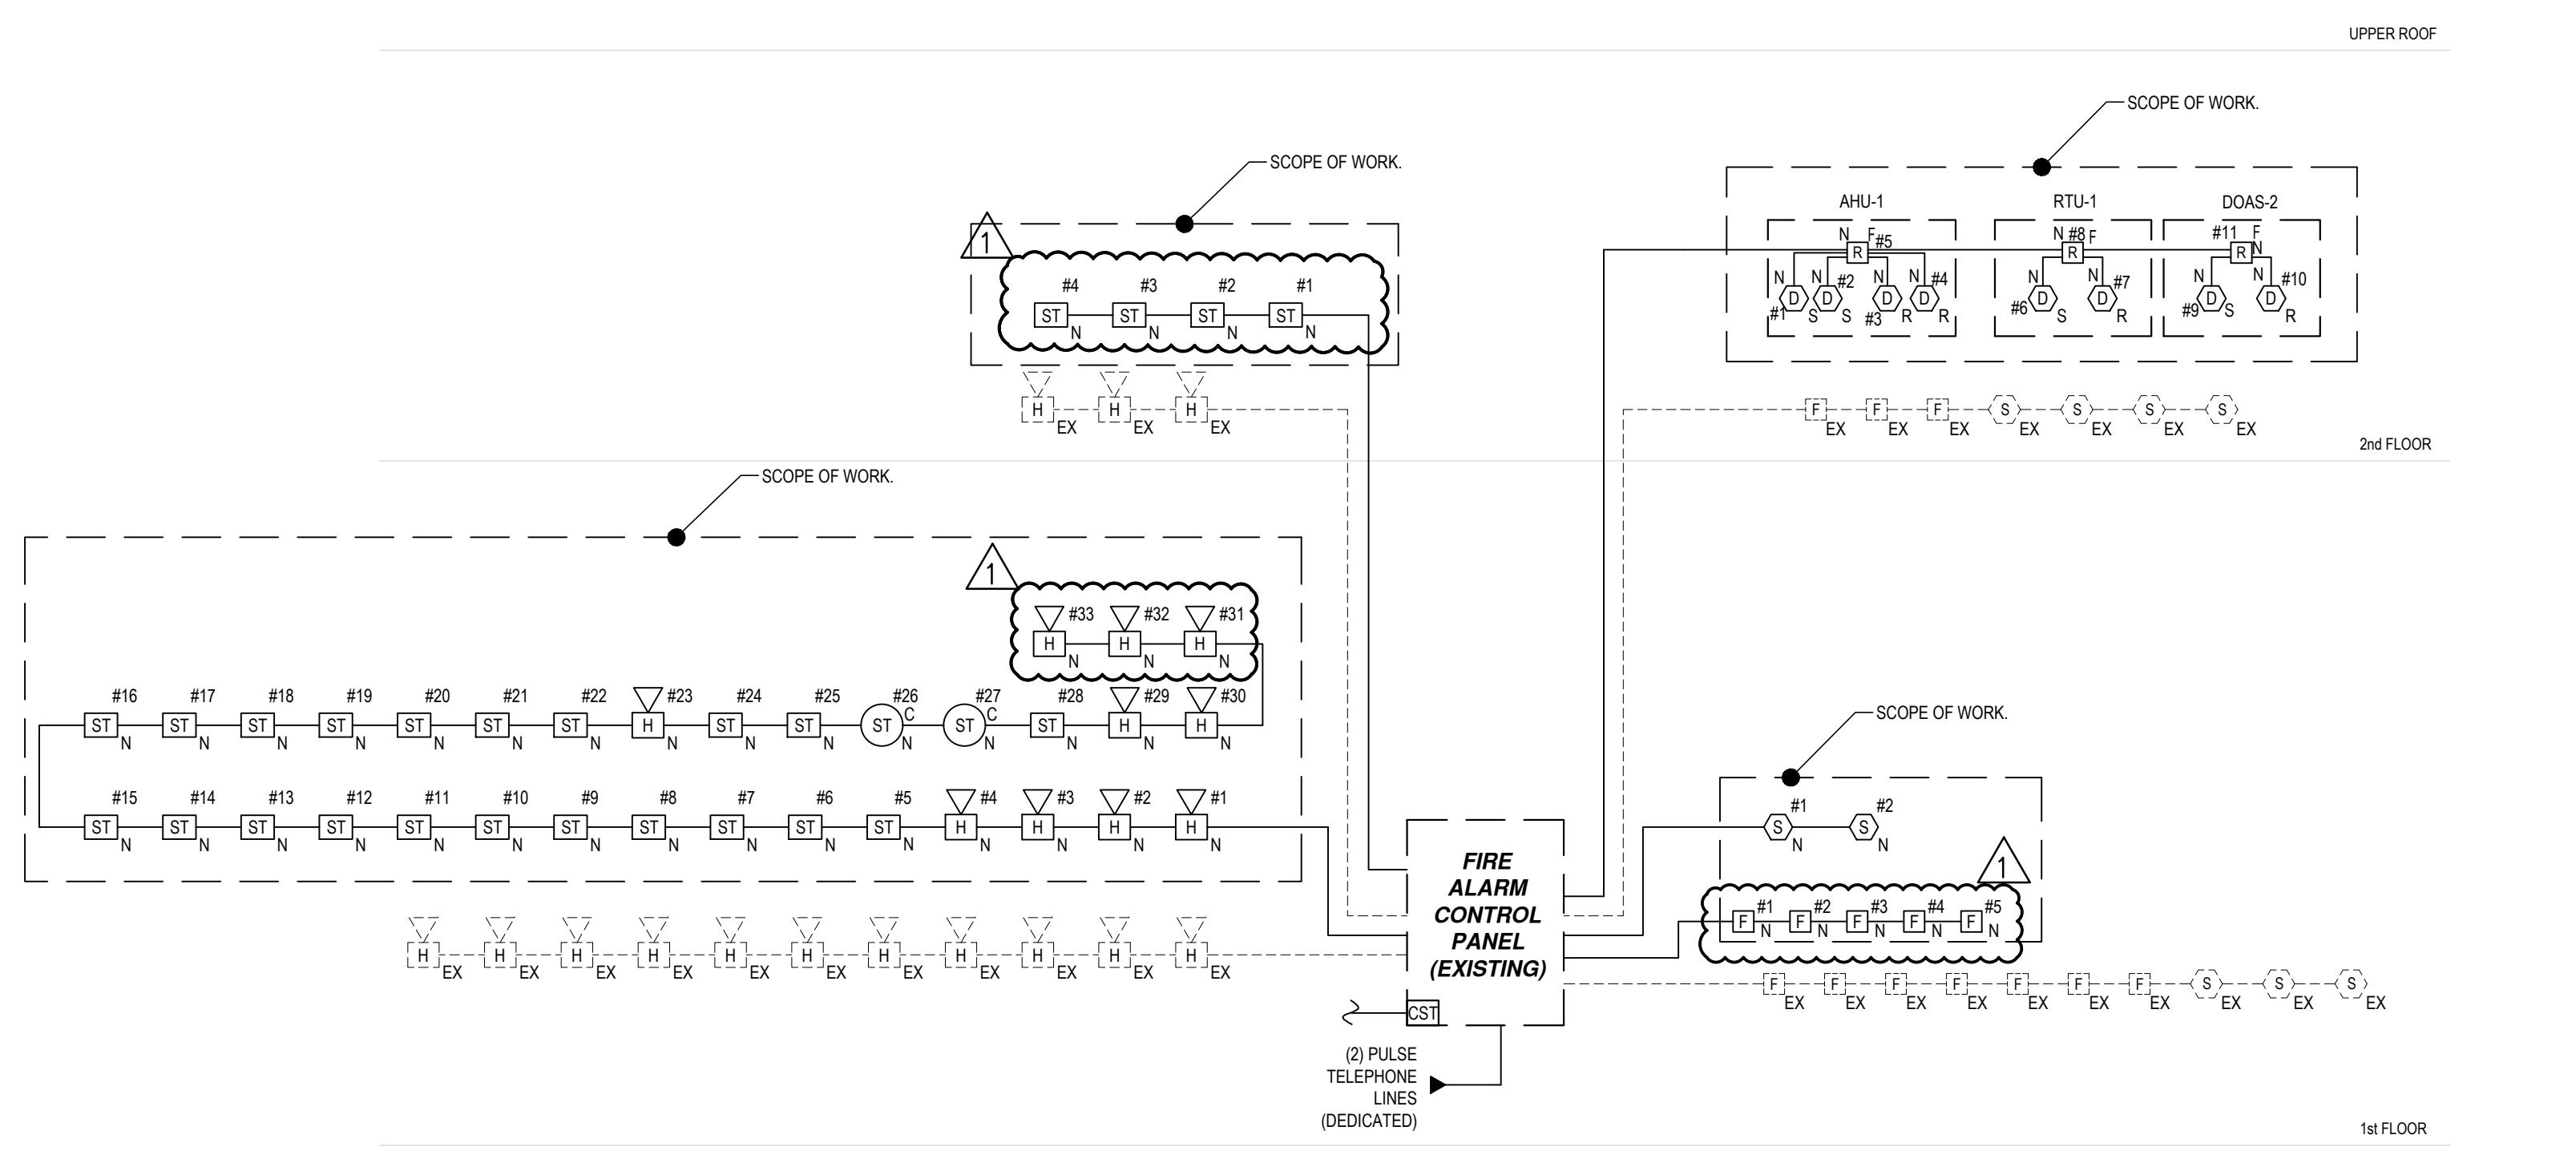

**FIRE ALARM RISER NOTES:**

1. USE EXISTING FIRE ALARM CONTROL PANEL TO PERFORM THE FIRE ALARM FUNCTIONS AS SPECIFIED HEREIN. EXISTING PANEL MAY BE REUSED IF FOUND TO BE CAPABLE OF SUPPORTING DEVICES AS INDICATED.
2. ALL DEVICES SHALL BE BUILDING STANDARD TYPE OR AS SPECIFIED.
3. SEE PLANS FOR LOCATION AND QUANTITIES OF FIRE ALARM DEVICES. ALL HORN AND STROBES SHALL BE WIRED ON ALTERNATE CIRCUITS.
4. ALL WIRING TO FIRE ALARM DEVICES SHALL BE TEFON COATED APPROVED FOR FIRE ALARM SYSTEM. RUN #14AWG MINIMUM EXPOSED IN ACCESSIBLE CEILING AREA. OTHERWISE RUN IN 3/4" EMT CONDUIT.
5. ALL SYSTEMS WIRING AND SEQUENCE OF OPERATION SHALL BE IN ACCORDANCE WITH THE LATEST NEW YORK STATE BUILDING CODE AND THE NEW YORK CITY FIRE DEPARTMENT REQUIREMENTS.
6. OBTAIN AND SUBMIT SHOP DRAWINGS FROM FIRE ALARM VENDOR WITH ALL DEVICES AND WIRING DIAGRAMS AS REQUIRED TO OBTAIN IN FIRE ALARM APPROVAL.
7. AFTER INSTALLATION OF ALL DEVICES AND COMPONENTS, PERFORM COMPLETE SYSTEM TESTS IN OWNERS AND BUILDINGS REPRESENTATIVE PRESENCE ON ALL FIRE ALARM DEVICES AS FOLLOWS:


  - A. TEST ALL DEVICES SERVING THE SPACE ON THE FIRE ALARM SYSTEM INCLUDING BUT NOT LIMITED TO SMOKE DETECTORS, FAN SHUT-DOWN RELAYS, DOOR RELEASE DEVICES, ETC.
  - B. VERIFY THAT ALL FIRE ALARM DEVICES UPON ACTIVATION CAUSE APPROPRIATE ANNUNCIATION AT THE FIRE ALARM CONTROL PANEL AND PROPER SEQUENCE OF OPERATION WITHIN THE PREMISES.
  - C. VERIFY THAT ALL CONTROL POINTS OPERATE PROPERLY WHEN INITIATED EITHER BY AN ALARM DEVICE WITHIN THE SPACE OR FROM THE FIRE CONTROL PANEL.
  - D. TEST HORN AUDIBILITY THROUGHOUT THE SPACE AND TEST STROBES.
  - E. SUBMIT WRITTEN TEST REPORT TO THE OWNER AND TO THE FIRE ALARM VENDOR.

**LEGEND:**

— EX EXIST. DEVICE/WIRING TO REMAIN  
— N NEW DEVICE/WIRING TO BE INSTALLED

APPROVED CLASS 'TEMPORAL 3' SYSTEM- FIRE ALARM RISER DIAGRAM

N.T.S.

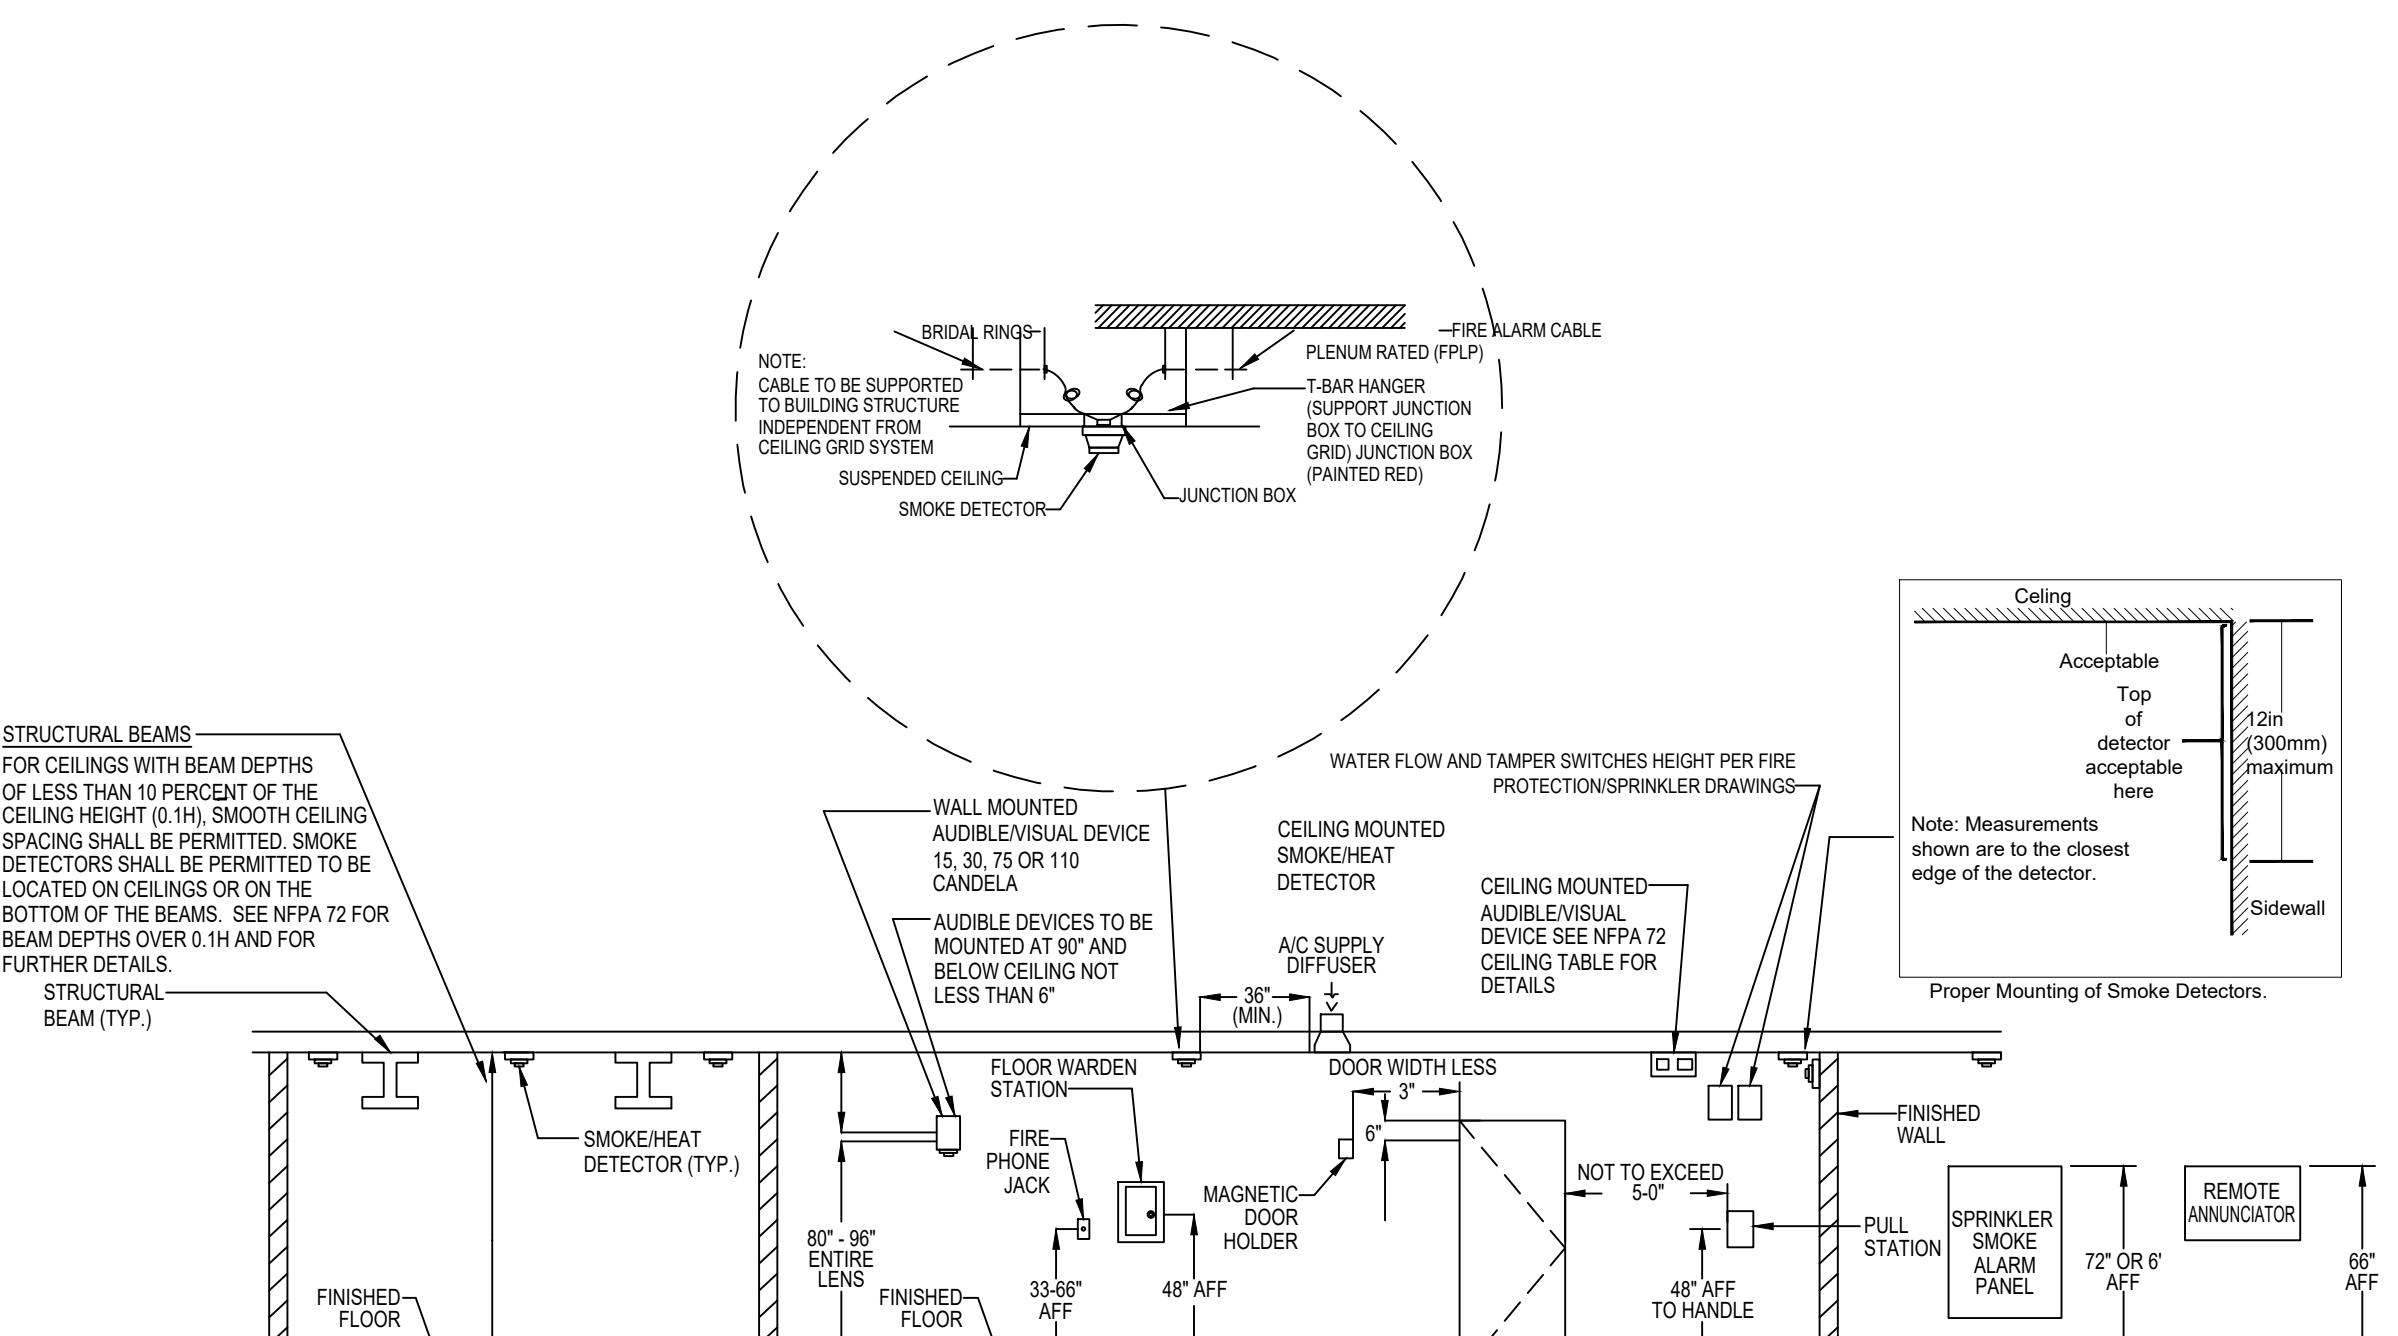

STANDARD FIRE ALARM DEVICE MOUNTING HEIGHTS

**NOTE:**  
1. REFER TO FLOOR PLANS FOR LOCATIONS.  
2. ALL FINAL MOUNTING HEIGHT MUST COMPLY WITH NFPA 72 AND AUTHORITY HAVING JURISDICTION.  
3. ALL INSTALLATION TO BE IN ACCORDANCE WITH MFG. RECOMMENDATIONS AND AS PER APPROVED SHOP DRAWINGS.  
4. MOUNTING HEIGHTS ARE SHOWN FOR COMPLIANCE WITH NFPA 72. NOT ALL DEVICES SHOWN ARE APPLICABLE TO THIS PROJECT.

		FIRE ALARM PANEL		ANNUN.		NOTIFICATION		FIRE SAFETY CONTROL																												
A	B	C	D	E	F	G	H	I	J	K	L	M	N	O	P	Q	R	S	T	U	V	W	X	Y	Z	AA	BB	CC	DD	EE	FF	GG				
1	MANUAL PULLSTATION	•						•										•																		
2	AREA SMOKE DETECTOR	•						•										•																		
3	DUCT SMOKE DETECTOR	•						•										•																		
4	HEAT DETECTOR	•						•										•																		
5	OPEN CIRCUIT	•						•										•																		
6	GROUNDED WIRE	•						•										•																		
7	A/C FAILURE	•						•										•																		
8	BATTERY FAULT	•						•										•																		
9	WIRE TO WIRE SHORT	•						•										•																		

EXISTING BUILDING TEMPORAL '3' FA SYSTEM MATRIX

1. THE EXISTING PROGRAMMED SEQUENCE OF OPERATION OF THE BUILDING FIRE ALARM SYSTEM SHALL BE MAINTAINED.
2. THE MODIFICATION AT THIS BUILDING IS REUSING EXISTING DEVICES AND WIRING, AND PROVIDE NEW TO MAINTAIN FIRE ALARM COVERAGE IN BUILDING AS PART OF SCOPE OF WORK.
3. IN RECONFIRMING OPERATION, TESTING SHALL INCLUDE ALL MANUAL INITIATING DEVICES, SMOKE DETECTOR, DUCT SUPPLY/RETURN DETECTORS, FIRE SMOKE DAMPERS, RELAYS, COMBINATION SPEAKER STROBE AND STROBE LIGHT, A/C SHUTDOWN SHALL BE MANUALLY RESTARTED.

UNAUTHORIZED ALTERATION OF ADDITION TO THIS DOCUMENT IS A VIOLATION OF SECTION 7209 OF THE NEW YORK STATE EDUCATION LAW.  
THE ENGINEER FOR THIS PROJECT (HEREOF) PREPARED BY OR BEARING THE SEAL OF THE  
ENGINEER, SHALL NOT BE REUSED FOR ANY EXTENSIONS OF THE PROJECT OR ANY OTHER  
PROJECT WITHOUT THE WRITTEN CONSENT OF THE ENGINEER.